



ELEVATION 01 scale 1:50

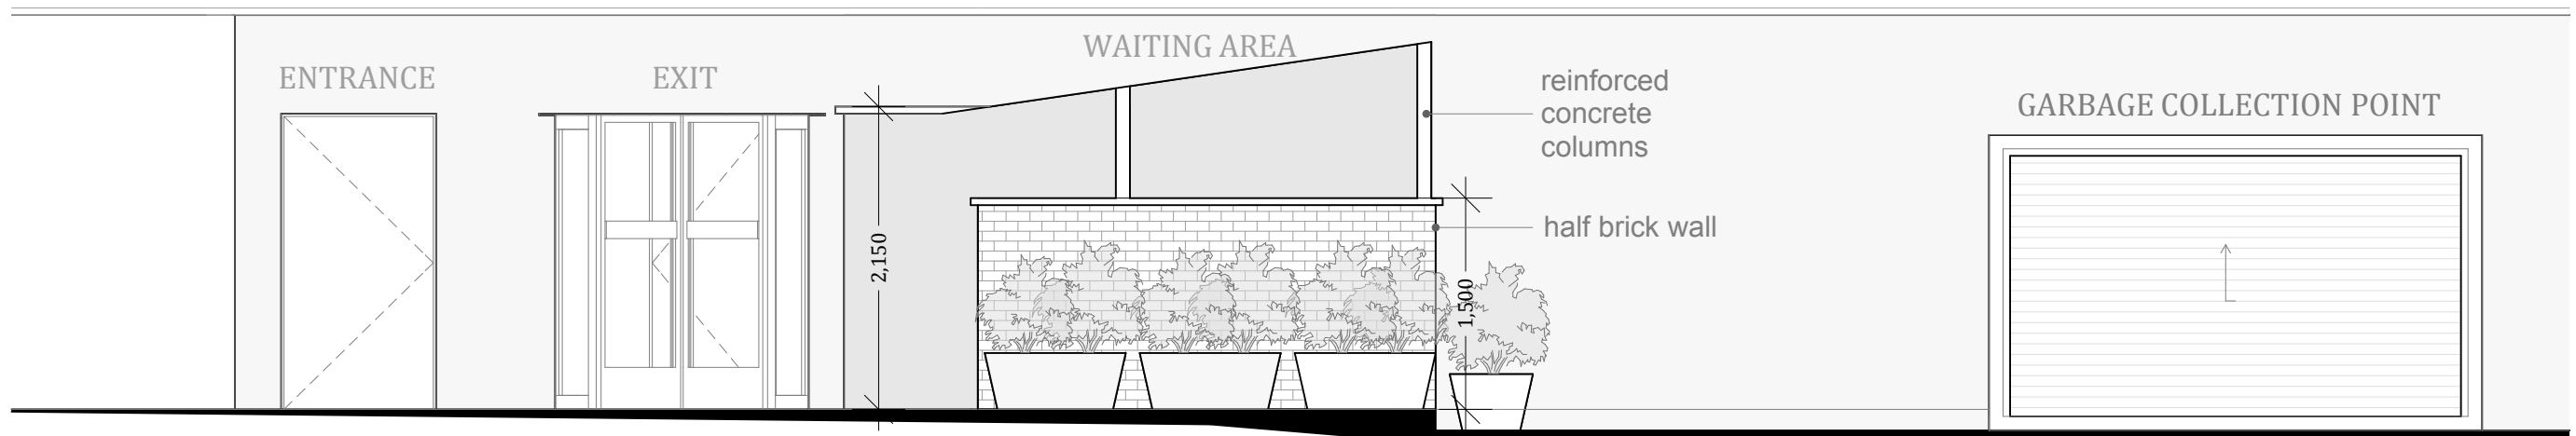

ELEVATION 02 scale 1:50

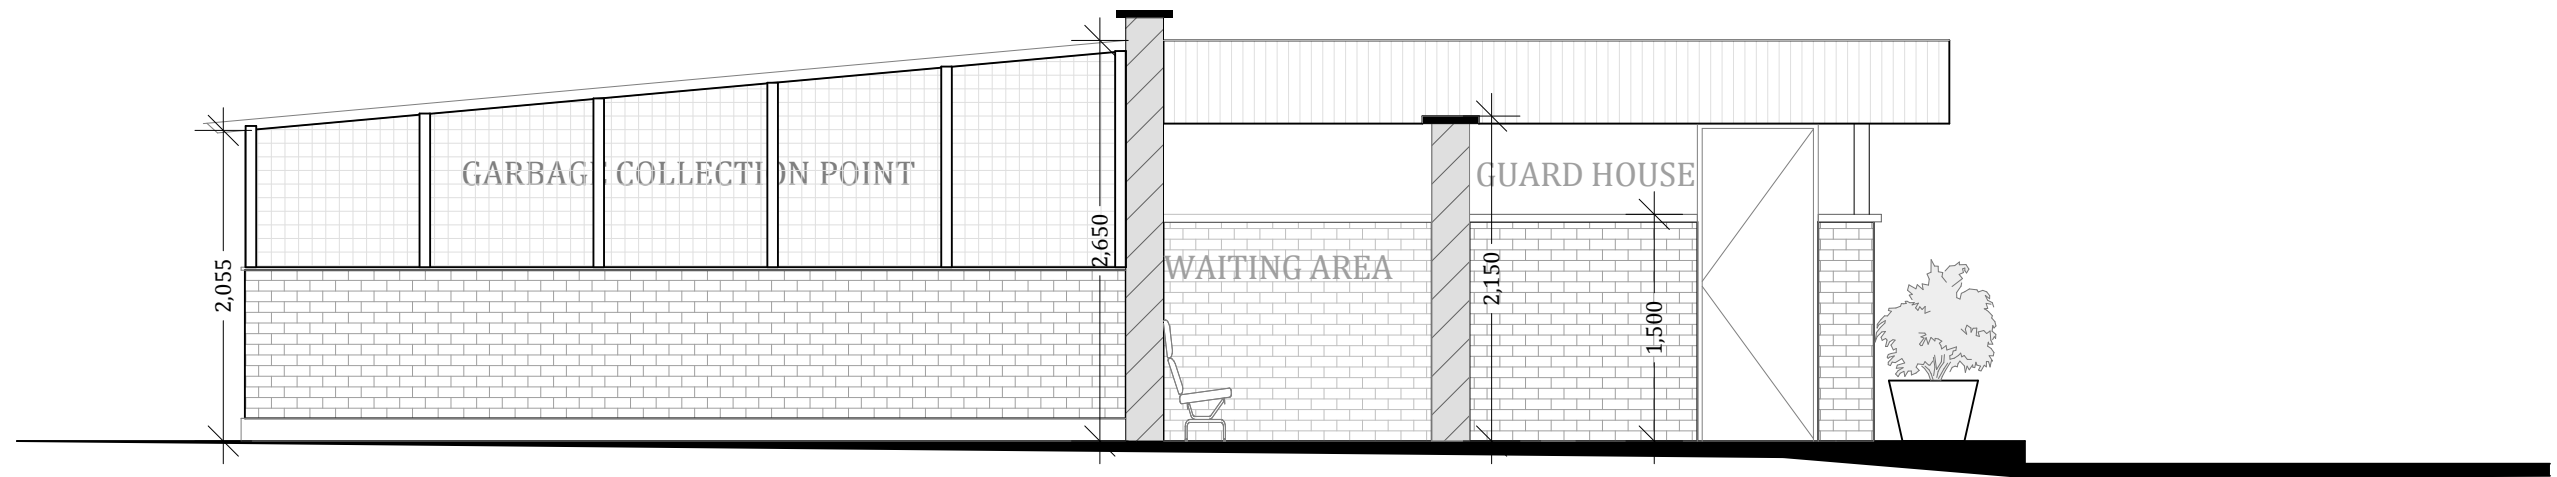

ELEVATION 03 scale 1:50

ALL DIMENSIONS SHALL BE CHECKED AND CORRELATED WITH RELEVANT DRAWINGS ON SITE. ANY DISCREPANCY SHALL BE BROUGHT TO THE NOTICE OF THE ARCHITECT.	Date	No.	REVISIONS	Date	No.	PRINTS TO	Concept By	Project	<div>Project Managers:</div> <div>  <div> WALTER CLAUDE & ASSOCIATES Architects & Planning Consultants Plot 45 , Kira Rd, Kamwokya. P.O.Box 8292 Kampala. Tel:031-2284704 </div> </div>
				DEC/14			WMS	AS BUILT FLOOR PLANS FOR US EMBASSY WAREHOUSES AND OFFICES, BUGOLOBI	
							Drawn By	N.C	
							Scale	Title	